


Addendum to As Built Plan Dated June 21, 1999  
 1035 Main Street, Hingham, MA  
 June 1, 2001

REVISED LOCATIONS


Distance To (Feet)	Corner "1"	Corner "2"
#1	24.4	44.7
#2	21.4	48.4
#3	19.3	51.6
#4DB	28.7	55.4
#5	36.5	53.4
#6	27.0	60.0
#7	62.0	91.0
#8	67.0	84.7
#9	64.0	87.0
#10	32.3	58.5
Pipe From House	2.6 ft.	

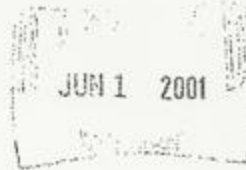

ELEVATIONS

NOTES

Location	Elevation	NOTES
Pipe Inv. @ House	97.19	1, Distance Pt. 7 to property line 34' +/-.
Pipe Inv. Tank In	96.50	
Pipe Inv. Tank Out	96.26	
DB Pipe Inv. In	95.96	2, DB has "T" installed.
DB Pipe Inv. Out	95.77	
Top Infiltrator End	96.18	3, SAS consists of 1 unit with 36 ft. of infiltrator in stone 40 ft. long
Top Of Stone	96.53	
Top Of Tank	97.90	
Basement Floor	92.00	4, Tee in Distribution Box
		5, Breakout Elevation 96.53
		6, Tank located in driveway.

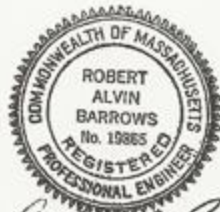

*Robert A. Barrows*

As Built Plan  
 For  
 Septic System  
 1035 Main Street  
 Hingham, MA  
 June 21, 1999  
 Robert A. Barrows P.E.  
 Hingham, MA

Designer's Name <u>OUT 701 749</u>	Designer's Name <u>150 Union St. Hingham</u>
Address <u>(381) 749-2859</u>	Address <u>(381) 749-2859</u>
Telephone #	Telephone #

Type of Building: Dwelling Lot Size 2.775 A Sq. feet  
 Dwelling — No. of Bedrooms 5 Garbage Grinder ( )  
 Other — Type of Building \_\_\_\_\_ No. of persons \_\_\_\_\_ Showers ( ). Cafeteria ( )  
 Other fixtures \_\_\_\_\_

Design Flow (min. required) 550 gpd Calculated design flow 550 gpd Design flow provided 550 gpd

Plan: Date 5-24-99 Number of sheets 1 Revision Date \_\_\_\_\_

Title Proposed Septic System, 1035 Main St., Hingham, MA

Description of Soil(s) Sand

Soil Evaluator Form No. 12 Name of Soil Evaluator B. McSwaney Date of Evaluation 2-31-99

DESCRIPTION OF REPAIRS OR ALTERATIONS Imfiltrators in stone (final diam = 50' x 11'), distribution box, 1500 G tank

The undersigned agrees to install the above described Individual Sewage Disposal System in accordance with the provisions of TITLE 5 and further agrees not to place the system in operation until a Certificate of Compliance has been issued by the Board of Health

Signed [Signature] Date 5/25/99

Inspections Final OK 6/16/99 and Final OK 6/14/99 probed OK 6/15/99

FORM 1 - APPLICATION FOR DSCP

DEP APPROVED FORM 5/96

No. 161-99

THE COMMONWEALTH OF MASSACHUSETTS

FEE 150

Hingham BOARD OF HEALTH

**CERTIFICATE OF COMPLIANCE**

Description of Work:  Individual Component(s)  Complete System

The undersigned hereby certify that the Sewage Disposal System; Constructed ( ) , Repaired ( ) , Upgraded ( ) , Abandoned ( )

R.A.D.

1035 Main St

has been installed in accordance with the provisions of 310 CMR 15.00 (Title 5) and the approved design plans/alterations relating to application No. 161-99 dated 6/9/99 Approved Design Flow 440

Inspector: [Signature] Inspector [Signature] Date 6/22/99

The issuance of this certificate shall not be construed as a guarantee that the system will function as designed.

FORM 1.3 - CERTIFICATE OF COMPLIANCE

DEP APPROVED FORM 5/96


161-99

THE COMMONWEALTH OF MASSACHUSETTS

FEE 150

Hingham BOARD OF HEALTH

**DISPOSAL SYSTEM CONSTRUCTION PERMIT**

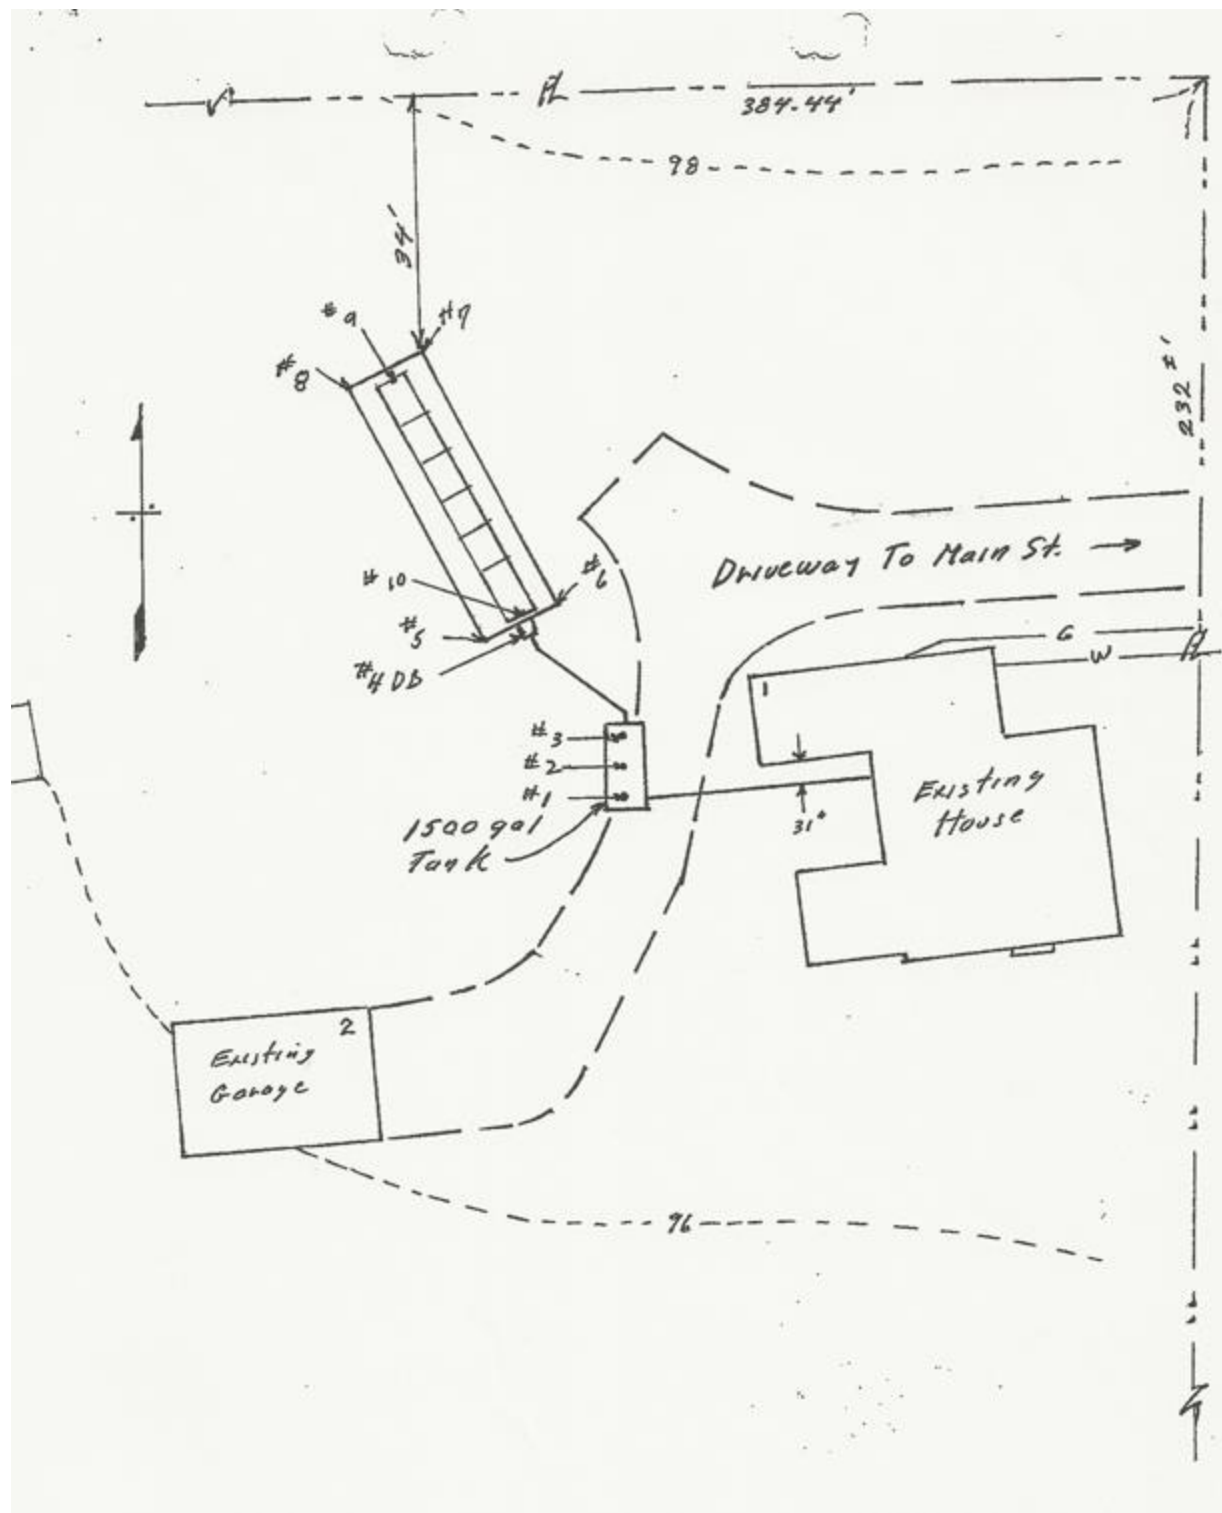



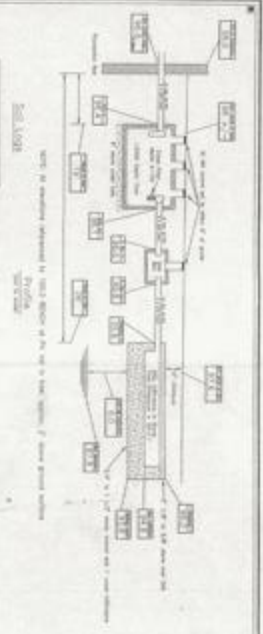


Table with 2 columns: Item, Description. Lists various site features and their locations.

Table with 2 columns: Item, Description. Lists various site features and their locations.


**NOTES:**

1. The site is located in the City of... (text partially obscured)
2. The site is bounded by... (text partially obscured)
3. The site is bounded by... (text partially obscured)
4. The site is bounded by... (text partially obscured)
5. The site is bounded by... (text partially obscured)
6. The site is bounded by... (text partially obscured)
7. The site is bounded by... (text partially obscured)
8. The site is bounded by... (text partially obscured)
9. The site is bounded by... (text partially obscured)
10. The site is bounded by... (text partially obscured)



Notes and annotations for the site plan, including a signature and date.

Notes and annotations for the site plan, including a signature and date.

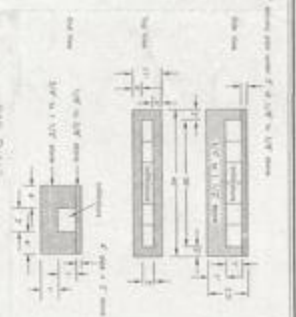

Notes and annotations for the site plan, including a signature and date.



Notes and annotations for the site plan, including a signature and date.

**MCS** Environmental Engineering Services

Professional Seal: State of Michigan, No. 12345, Expires 12/31/2024

Project: 12345 Main Street, Detroit, MI 48201

Client: ABC Company, 12345 Main Street, Detroit, MI 48201

Date: 12/31/2024

Scale: 1" = 100'

HEALTHY DEPT.

APPROVED