




JAMES L. NABSTEDT PLS No. 39693

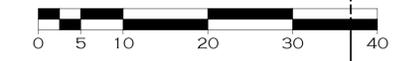

PARTIAL PROJECT AS-BUILT
 FOR
 HINGHAM
 CONSERVATION COMMISSION
 SHOWING
 RIDGEWOOD CROSSING
 CONDOMINIUM
 IN
 HINGHAM, MASS.

JAMES L. NABSTEDT P.L.S.
 16 CONNELL STREET QUINCY MASS. 02169
 TEL 617.947.2520

C:\Users\jlnab\Desktop\Ridgewood Permitt_Topo 2024\Ridgewood Permitt_Topo 12-27-24.dwg, 1/7/2025 8:39:28 AM, AutoCAD PDF (High Quality Print).pc3

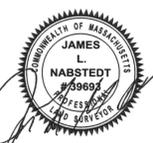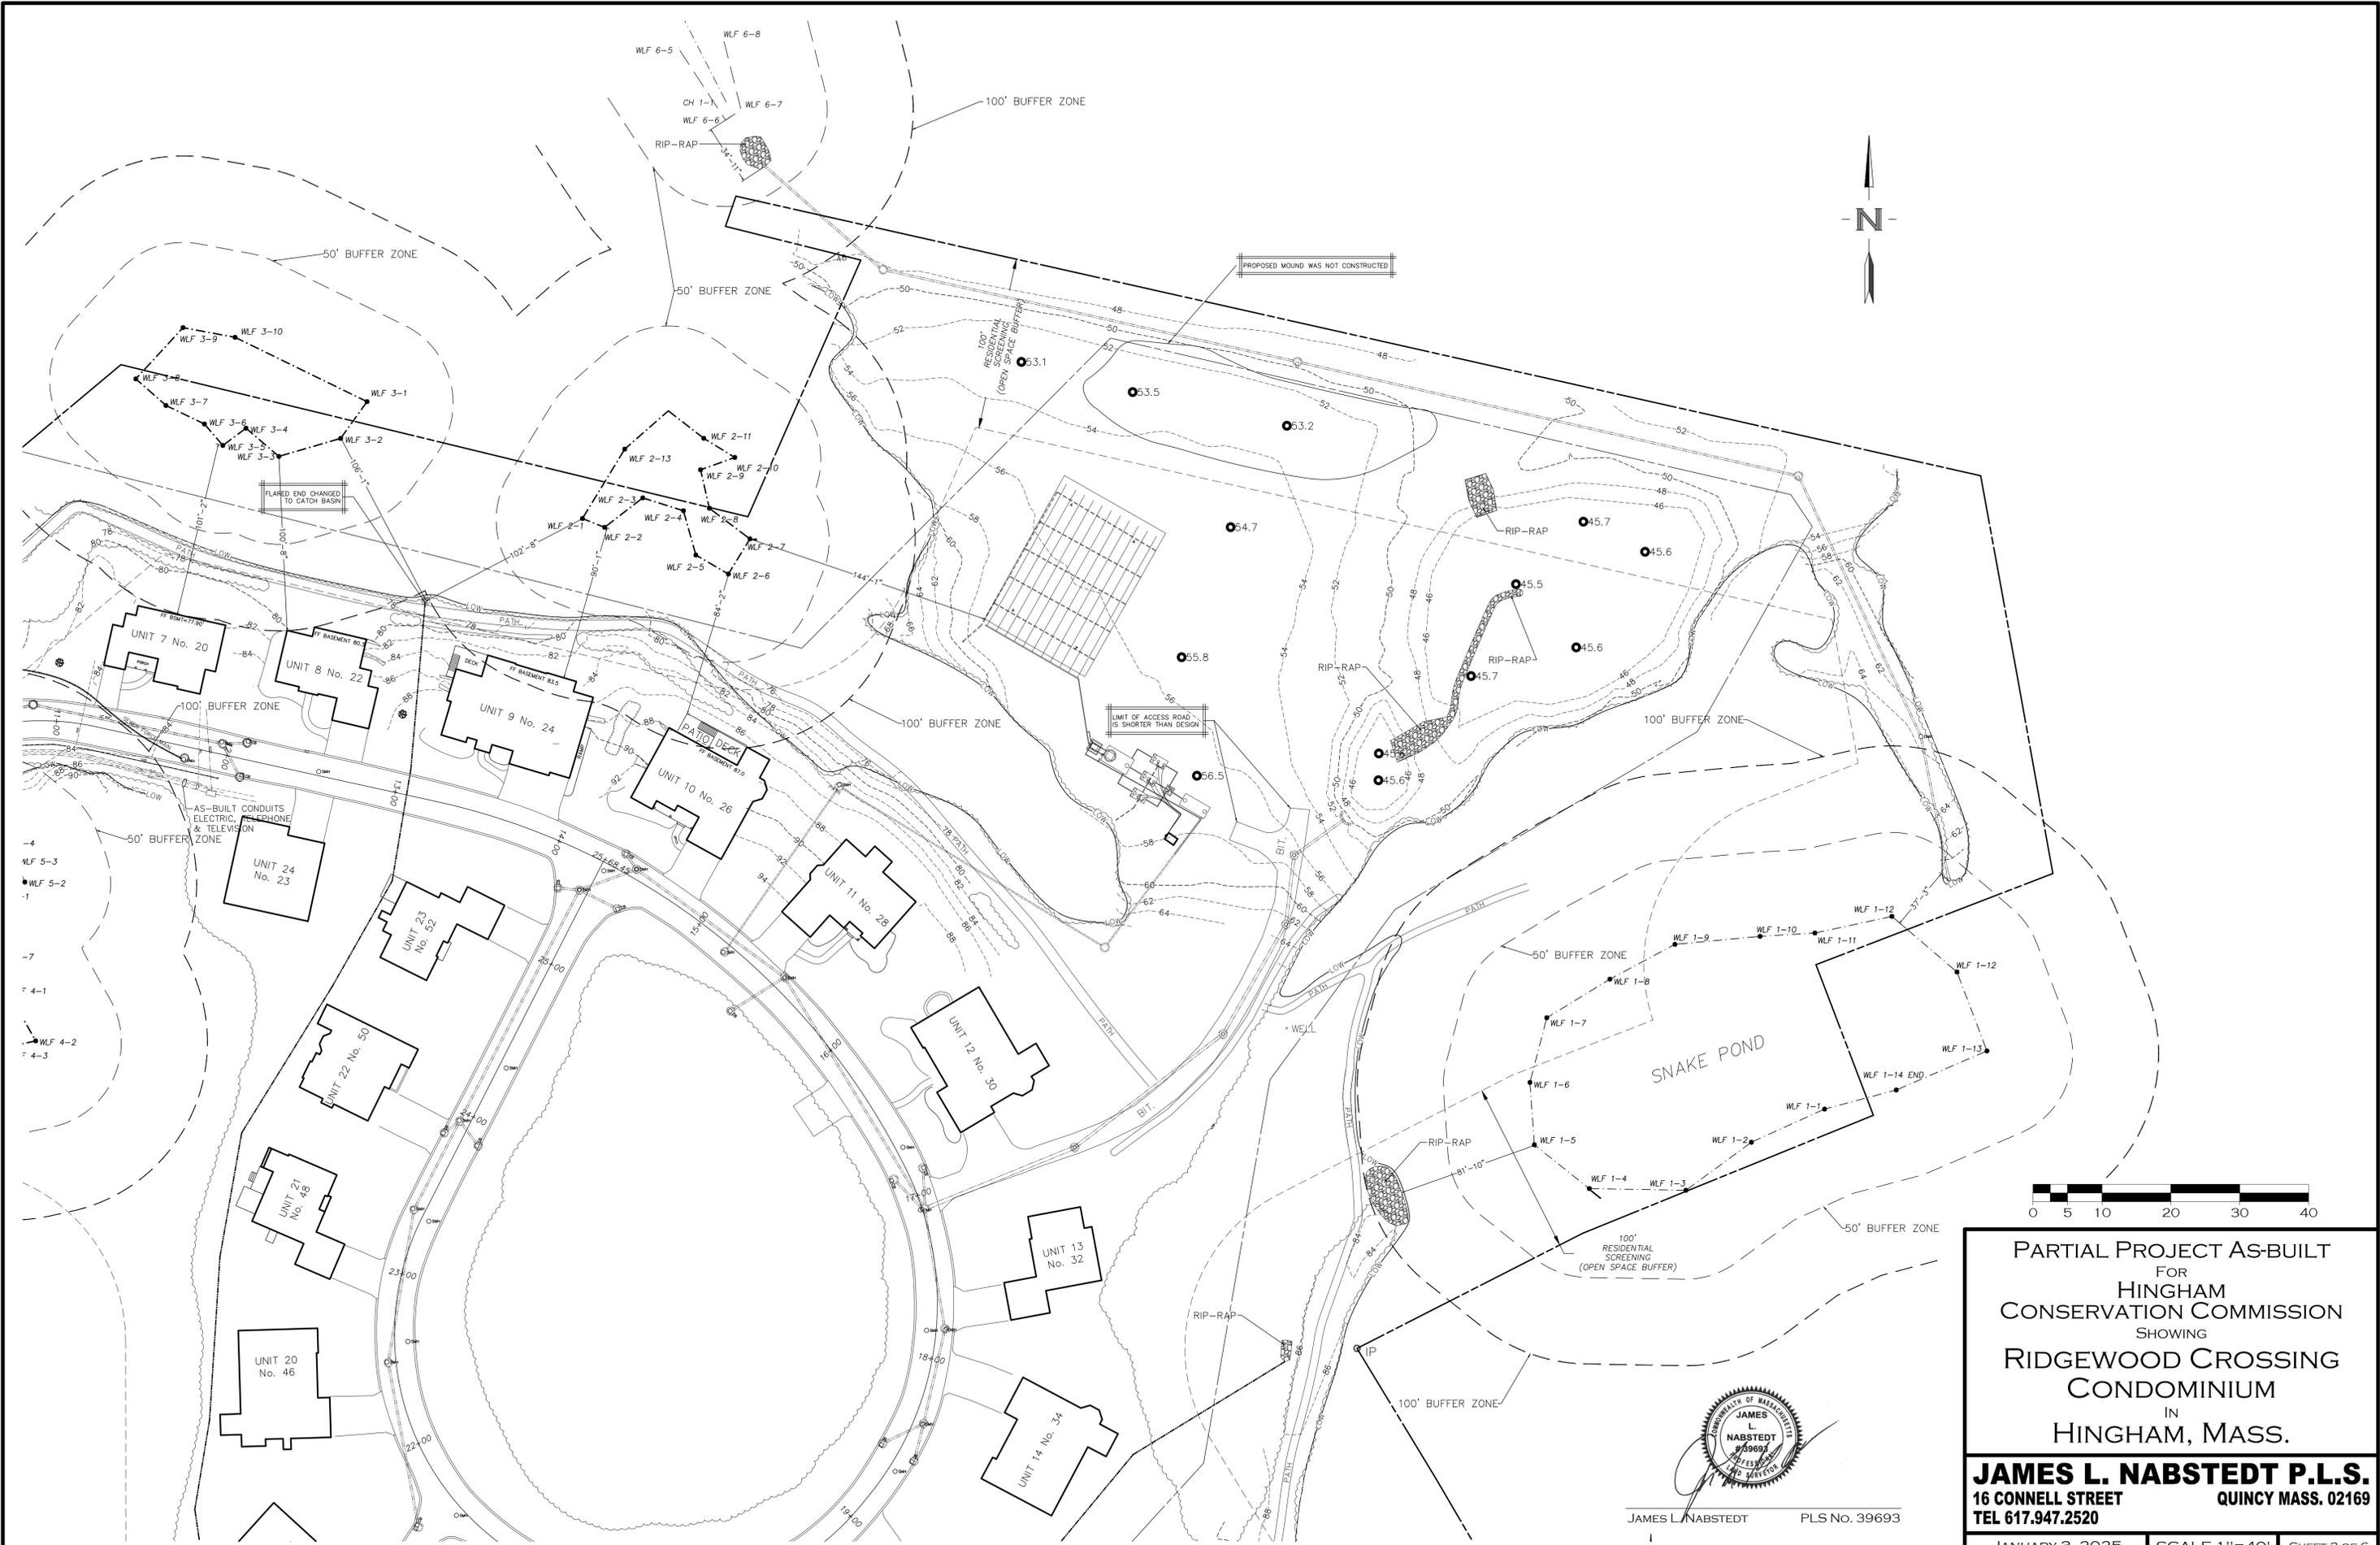


JAMES L. NABSTEDT PLS No. 39693

PARTIAL PROJECT AS-BUILT
 FOR
 HINGHAM
 CONSERVATION COMMISSION
 SHOWING
 RIDGEWOOD CROSSING
 CONDOMINIUM
 IN
 HINGHAM, MASS.

JAMES L. NABSTEDT P.L.S.
 16 CONNELL STREET QUINCY MASS. 02169
 TEL 617.947.2520

C:\Users\jpl\OneDrive\Desktop\Ridgewood\Topo 2024\Ridgewood\Topo 12-27-24.dwg, 1/7/2025 9:39:32 AM, AutoCAD PDF (High Quality Print).pc3

C:\Users\jplius\Desktop\Ridgewood\Permit_Topo_2024\Ridgewood_Topo_12-27-24.dwg, 1/7/2025 8:39:37 AM, AutoCAD PDF (High Quality Print).pc3

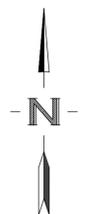

JAMES L. NABSTEDT PLS No. 39693



PARTIAL PROJECT AS-BUILT
FOR
HINGHAM
CONSERVATION COMMISSION
SHOWING
RIDGEWOOD CROSSING
CONDOMINIUM
IN
HINGHAM, MASS.

JAMES L. NABSTEDT P.L.S.
16 CONNELL STREET QUINCY MASS. 02169
TEL 617.947.2520


C:\Users\jplius\Desktop\Ridgewood\Permit_Topo_2024\Ridgewood_Topo_12-27-24.dwg, 1/7/2025 8:39:42 AM, AutoCAD PDF (High Quality Print).pc3




 JAMES L. NABSTEDT PLS No. 39693



PARTIAL PROJECT AS-BUILT
 FOR
 HINGHAM
 CONSERVATION COMMISSION
 SHOWING
**RIDGEWOOD CROSSING
 CONDOMINIUM**
 IN
 HINGHAM, MASS.

JAMES L. NABSTEDT P.L.S.
 16 CONNELL STREET QUINCY MASS. 02169
 TEL 617.947.2520

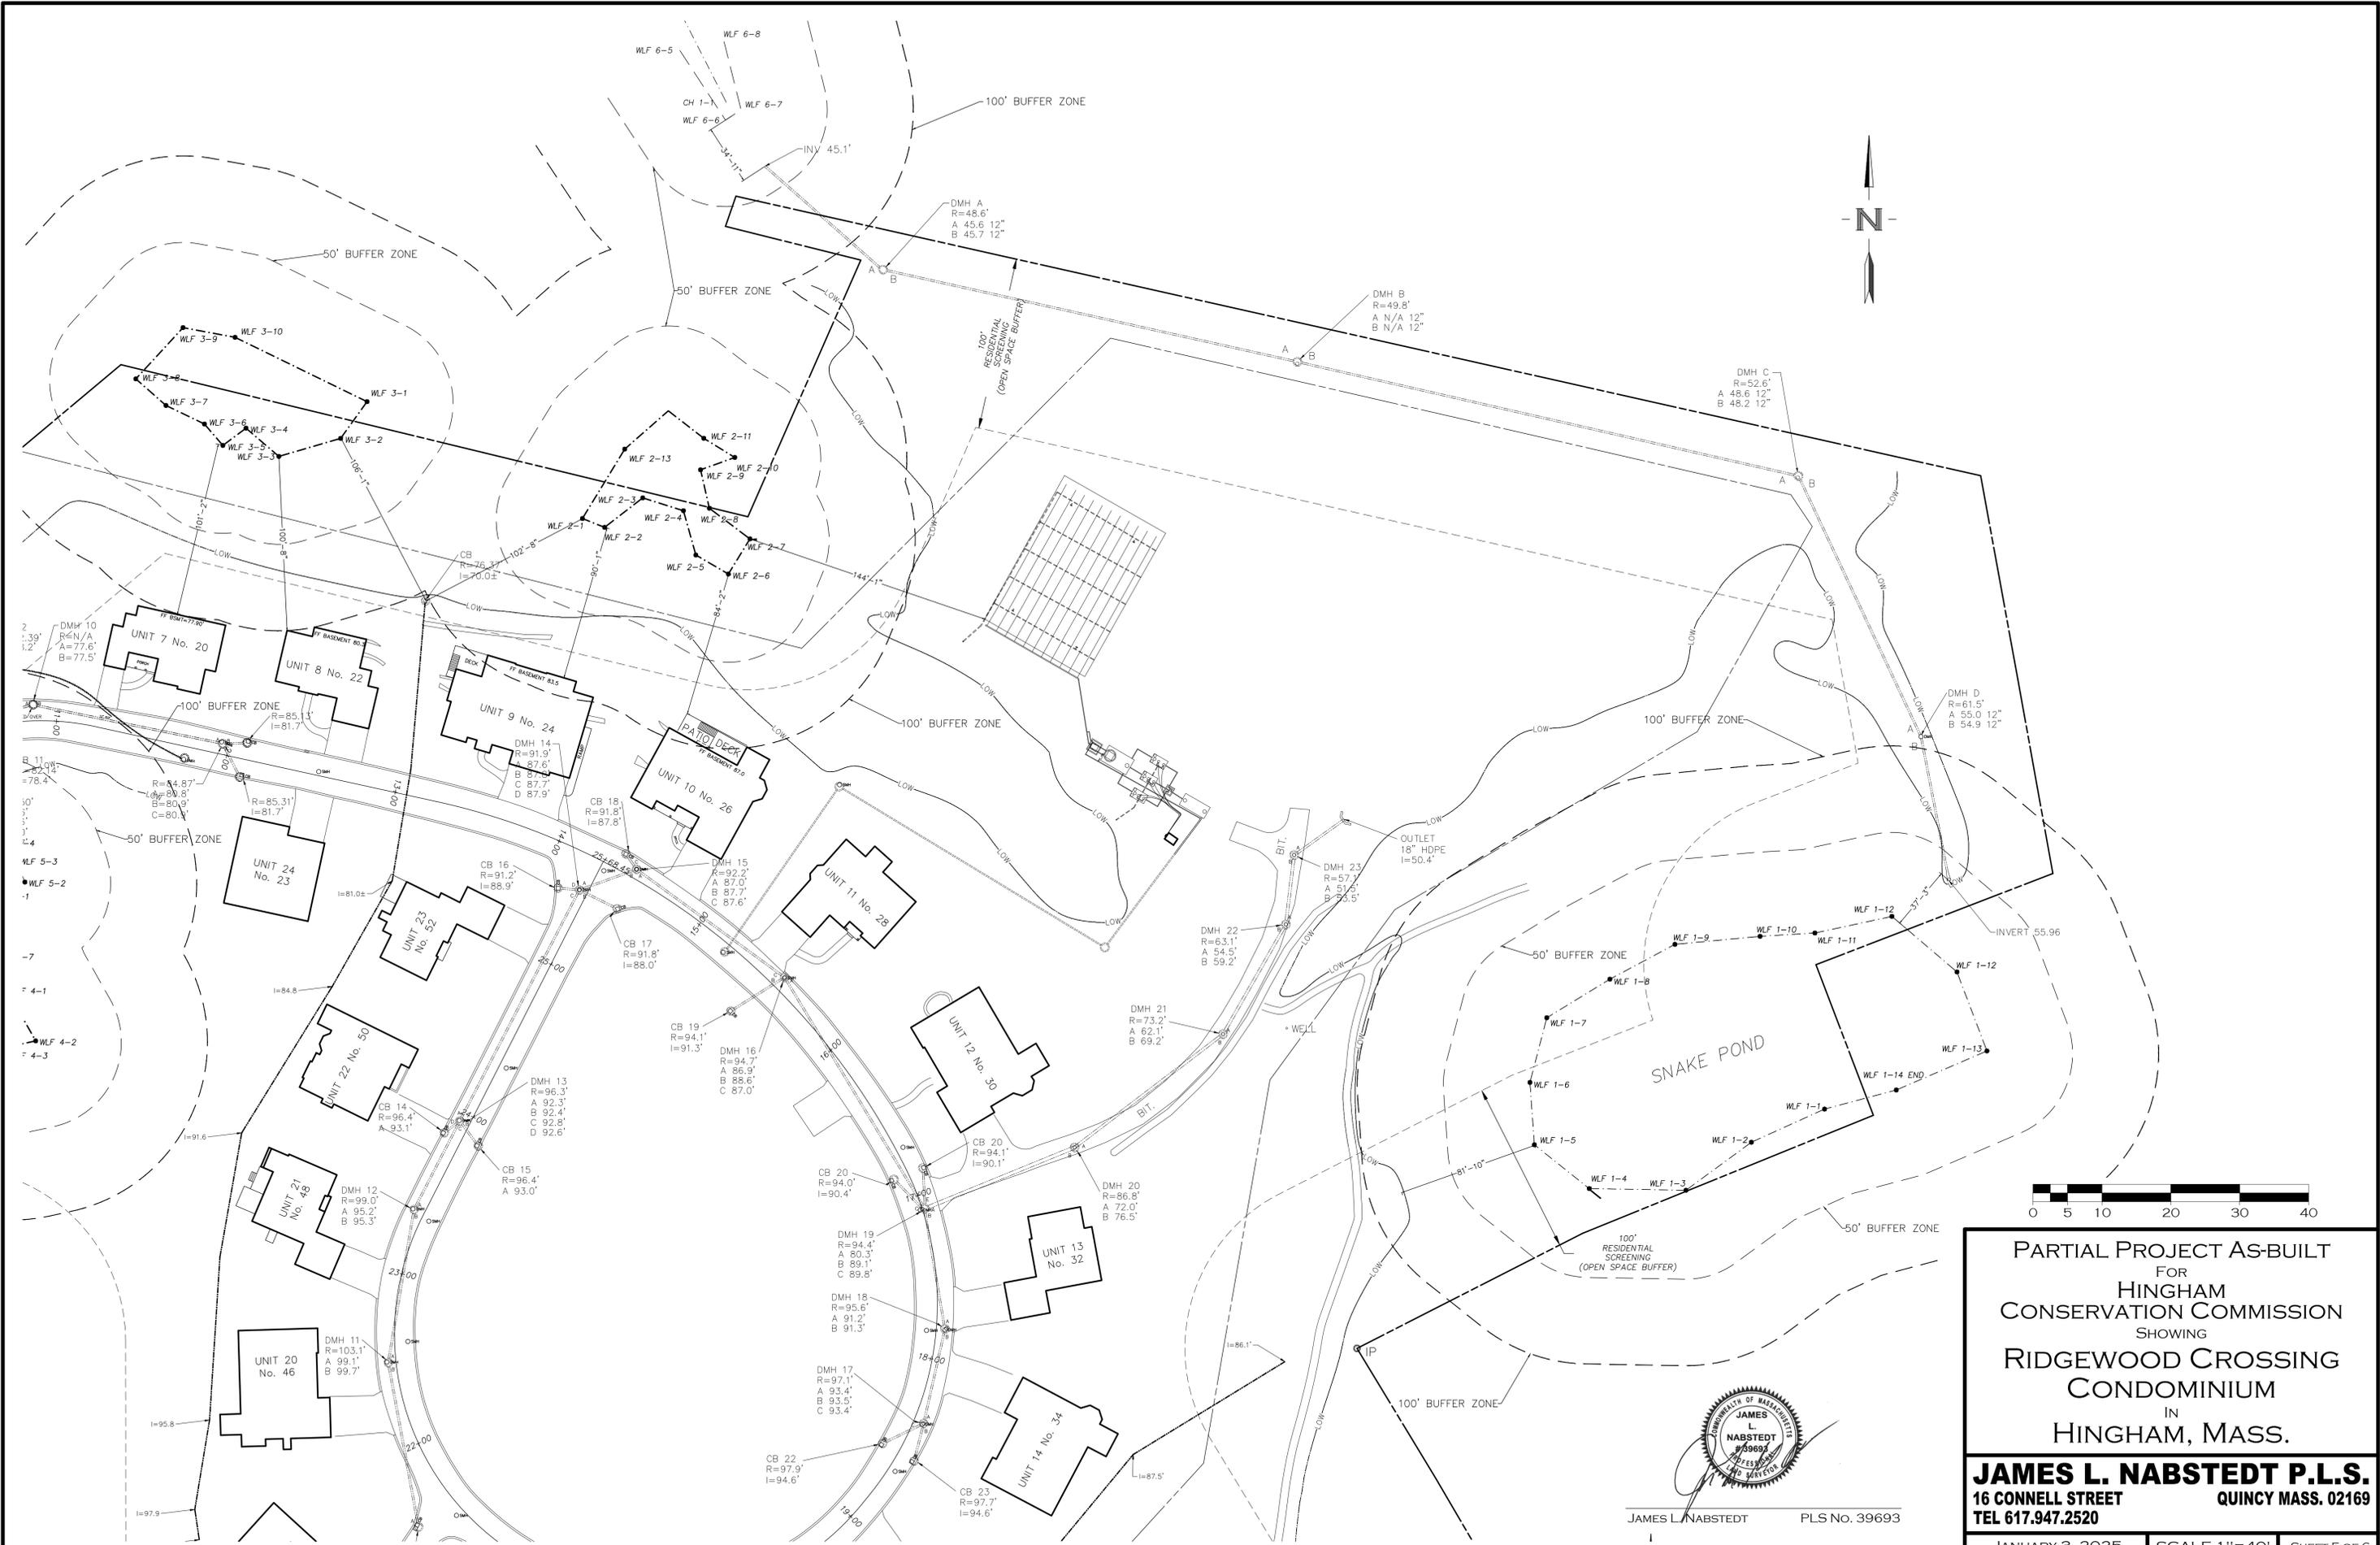


PARTIAL PROJECT AS-BUILT
 FOR
 HINGHAM
 CONSERVATION COMMISSION
 SHOWING
 RIDGEWOOD CROSSING
 CONDOMINIUM
 IN
 HINGHAM, MASS.

JAMES L. NABSTEDT P.L.S.
 16 CONNELL STREET
 TEL 617.947.2520
 QUINCY MASS. 02169

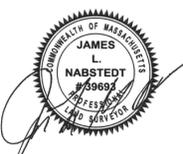

JAMES L. NABSTEDT PLS No. 39693

C:\Users\jplius\Desktop\Ridgewood\Permit_Topo_2024\Ridgewood_Topo_12-27-24.dwg, 1/7/2025 8:39:52 AM, AutoCAD PDF (High Quality Print).pc3

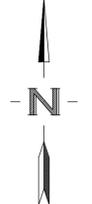

100'
RESIDENTIAL
SCREENING
(OPEN SPACE BUFFER)

100'
RESIDENTIAL
SCREENING
(OPEN SPACE BUFFER)

100' BUFFER ZONE

SB/OH






JAMES L. NABSTEDT PLS No. 39693



PARTIAL PROJECT AS-BUILT
FOR
HINGHAM
CONSERVATION COMMISSION
SHOWING
RIDGEWOOD CROSSING
CONDOMINIUM
IN
HINGHAM, MASS.

JAMES L. NABSTEDT P.L.S.
16 CONNELL STREET QUINCY MASS. 02169
TEL 617.947.2520

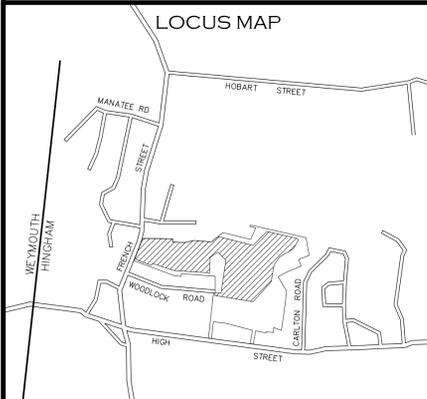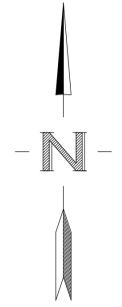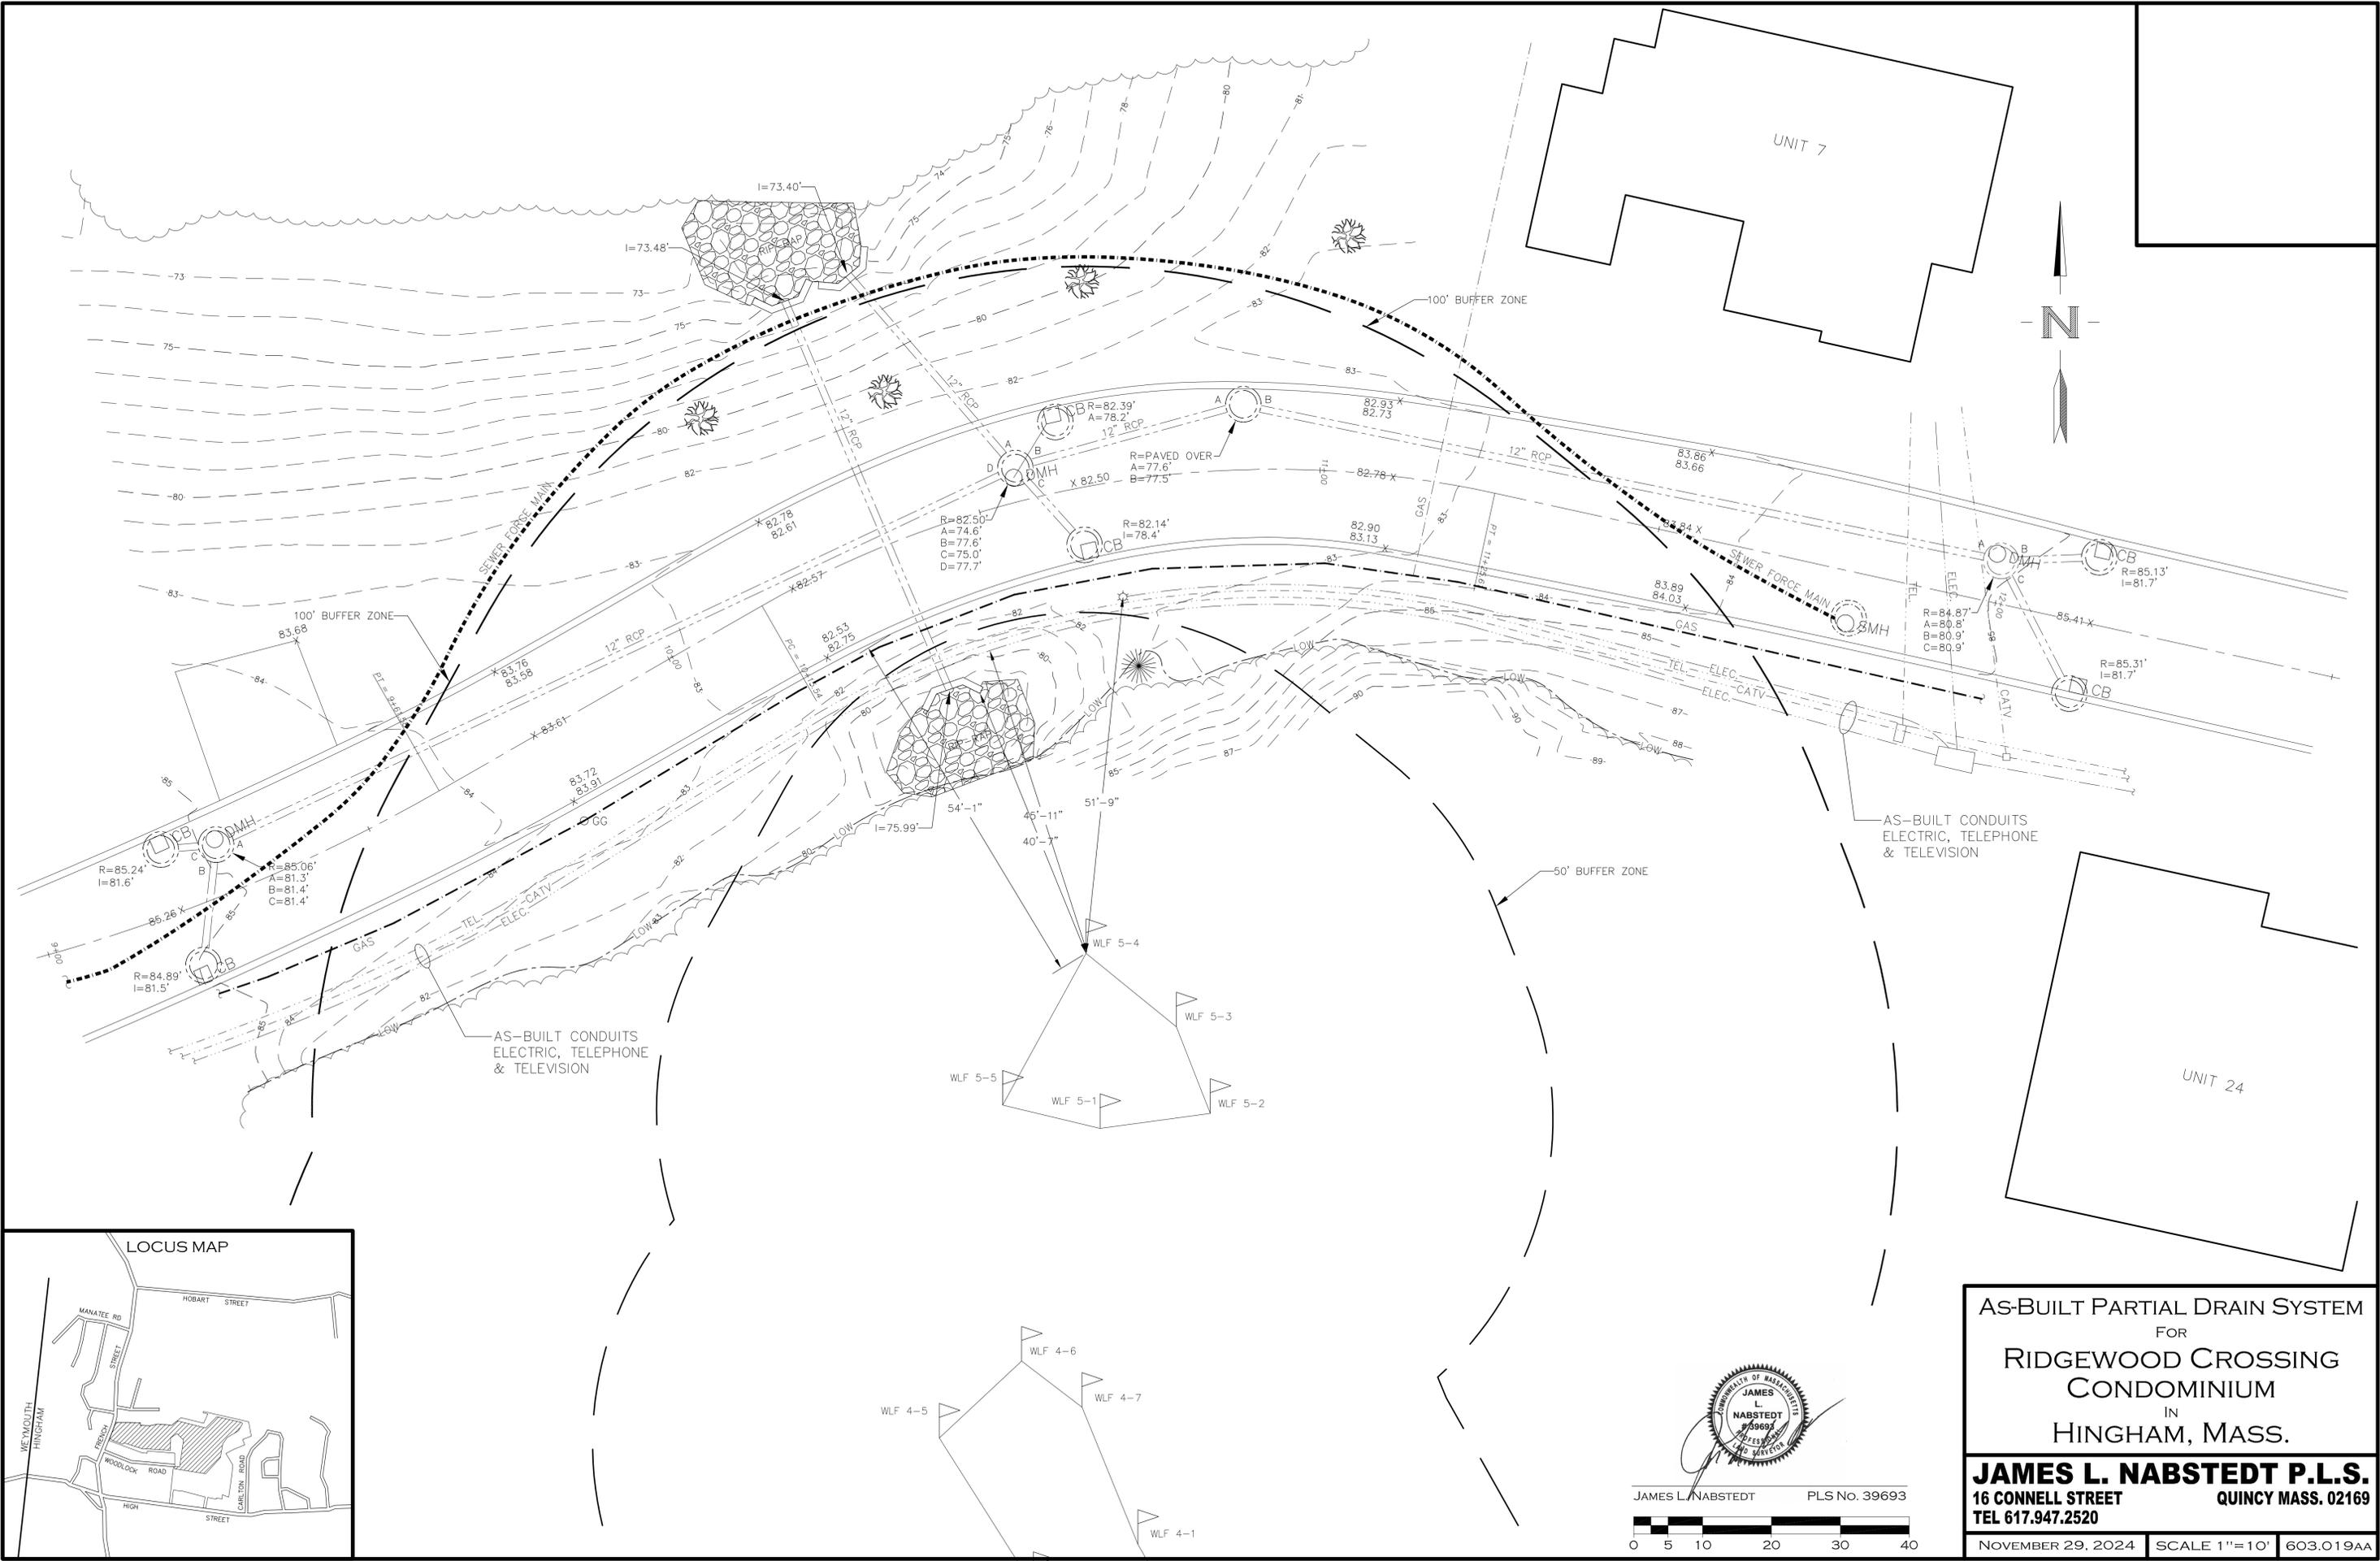

JAMES L. NABSTEDT
 PLS No. 39693
 A scale bar showing increments of 5 units from 0 to 40.

AS-BUILT PARTIAL DRAIN SYSTEM
 FOR
RIDGEWOOD CROSSING
CONDOMINIUM
 IN
HINGHAM, MASS.
JAMES L. NABSTEDT P.L.S.
 16 CONNELL STREET QUINCY MASS. 02169
 TEL 617.947.2520
 NOVEMBER 29, 2024 SCALE 1"=10' 603.019AA