

AS-BUILT EXHIBIT

ASSESSORS MAP 213 LOT 5 & 15



1 & 15 TECHNOLOGY PLACE – HINGHAM, MA




John Green
6-3-25


RECORD OWNER:
ASSESSORS MAP 213
LOT 5 AND LOT 15
1 AND 15 TECHNOLOGY PLACE
HINGHAM, MA 02043

PERRY ROCKLAND, LLC
20 WINTHROP SQUARE
BOSTON, MA 02110
DEED BOOK 18903 PAGE 91
DEED BOOK 30206 PAGE 157

PURPOSE OF THE PLAN:
THE PURPOSE OF THIS PLAN IS TO HORIZONTALLY DEPICT THE LOCATION OF THE EXISTING IMPROVEMENTS RELATED TO THE OPEN ORDER OF CONDITIONS AND THEIR PROXIMITY TO THE ONSITE WETLANDS.

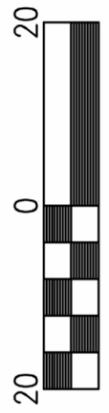

SCALE IN FEET

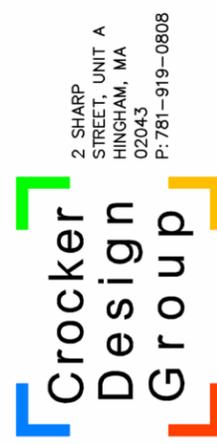

SCALE: 1"=20'
DATE: 6-3-2025
JOB NO: 125-013