




8/6/2025

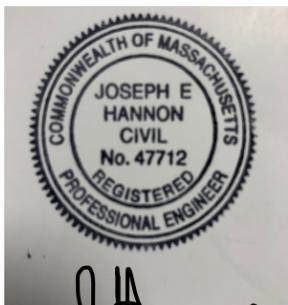

Handwritten signature of Joseph E. Hannon

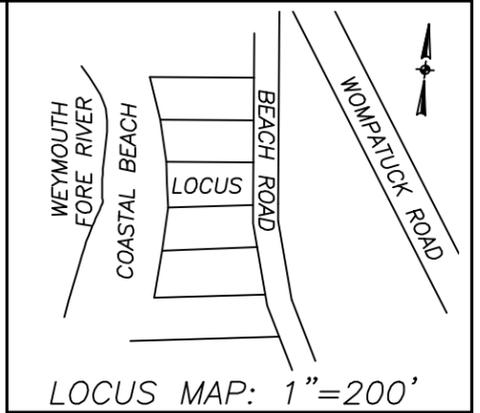


WEYMOUTH
BACK RIVER

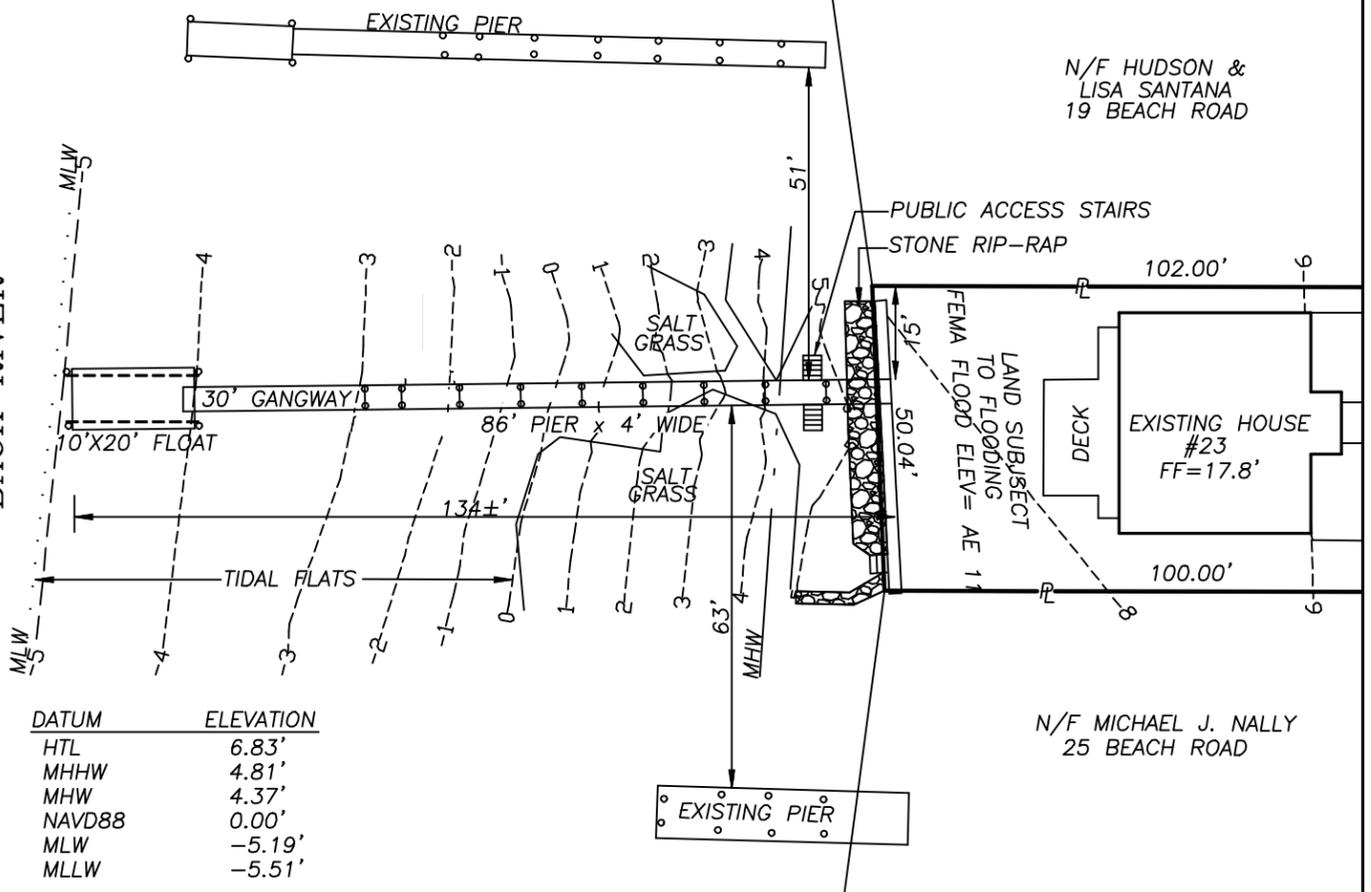

| DATUM | ELEVATION |
|--------|-----------|
| HTL | 6.83' |
| MHHW | 4.81' |
| MHW | 4.37' |
| NAVD88 | 0.00' |
| MLW | -5.19' |
| MLLW | -5.51' |

BASED ON NOAA TIDE STATION
WEYMOUTH FORE RIVER MA
#8444788 FOR THE 1983
TIDAL EPOCH.

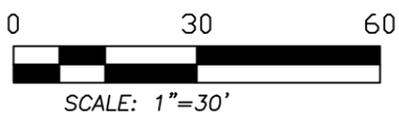

AS-BUILT LAYOUT FOR COC
8/6/2025

23 BEACH RD.
HINGHAM, MA.
02043