
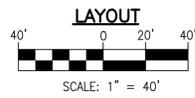


VICINITY MAP  
NOT TO SCALE

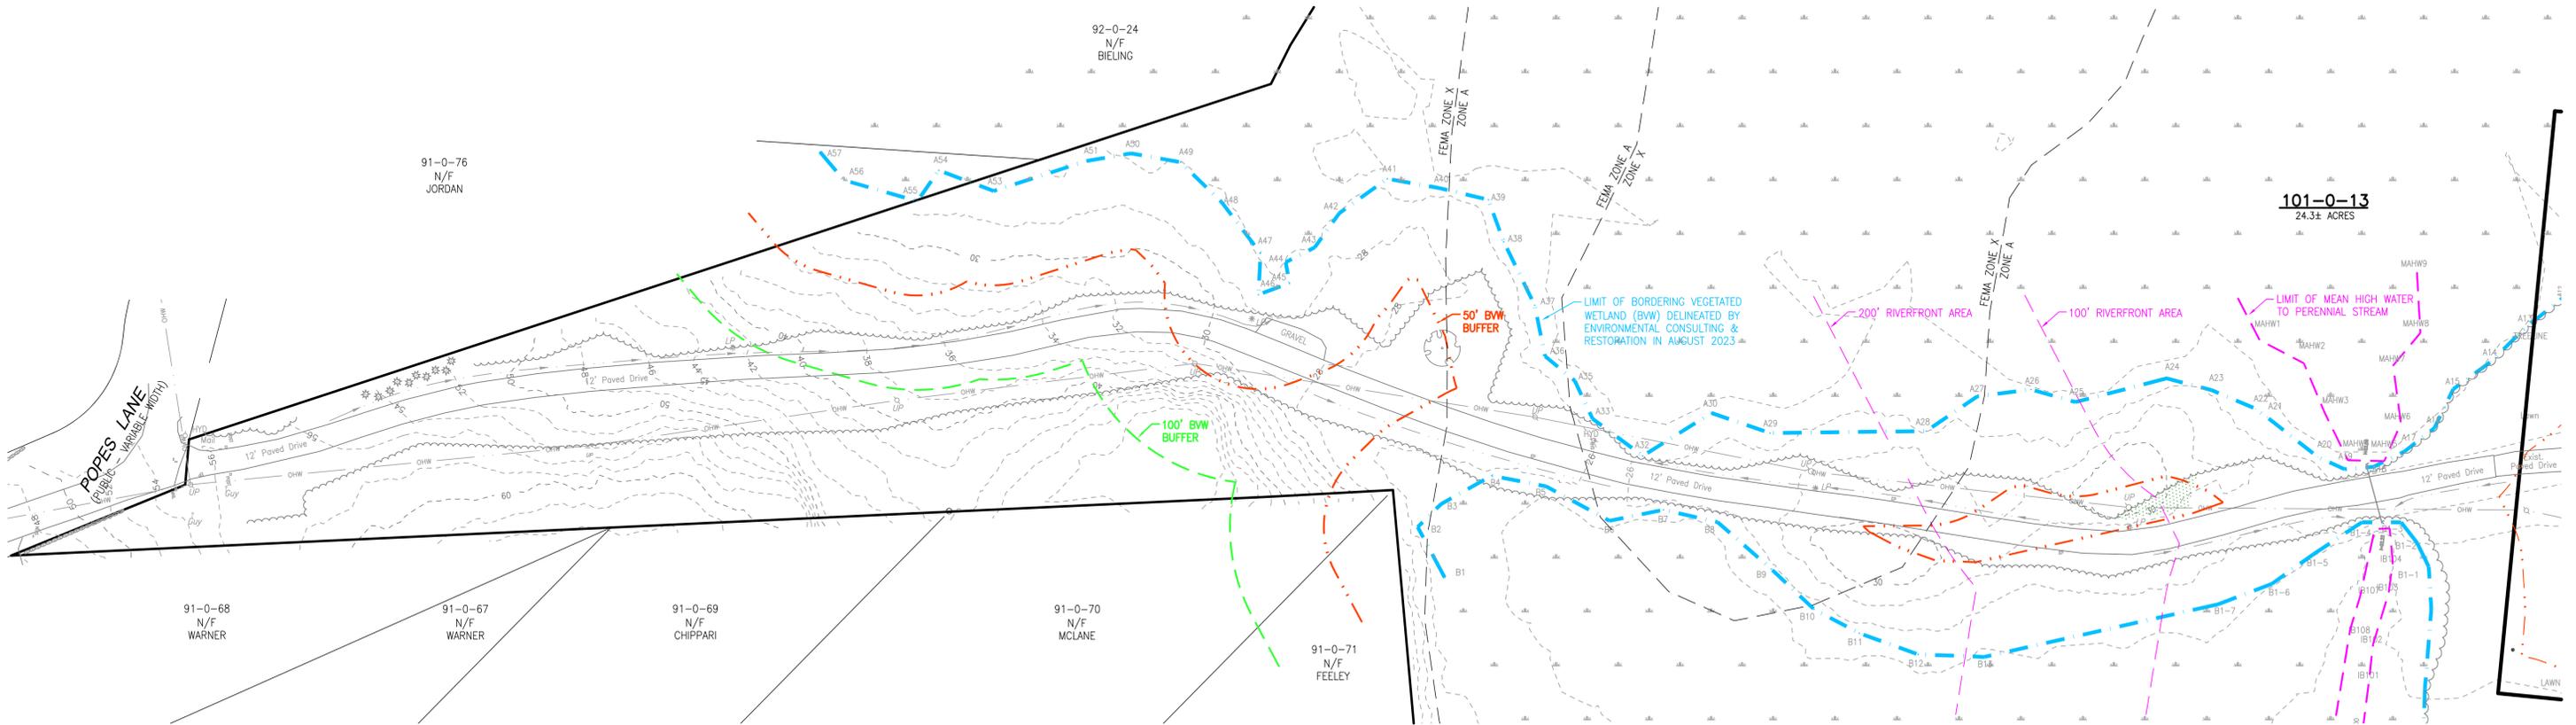

	PREPARED BY:	
	PROJECT:	
DESIGN:	JMH	
CHECK:	GJM	
JOB NO:	21-161	
DATE:	8/5/2025	
REVISION:		
APPLICANT:	JOSEPH & KATHRYN CRESPO	
PLAN TITLE:	DRIVEWAY IMPROVEMENTS AS-BUILT SITE PLAN	
SHEET:	1 OF 1	