



BACK LEFT CORNER OF HOUSE



BACK LEFT CORNER OF HOUSE



ROCK WALLS ALONG DRIVEWAY AT BACK OF DRIVEWAY



BACK LEFT CORNER OF HOUSE
(Note Outfall Pipe)



REAR OF DWELLING



WALKWAY & DECK AT REAR OF DWELLING



WALKWAY AT SIDE OF DWELLING



FRONT YARD
AT RIGHT SIDE OF DRIVEWAY



FRONT YARD
AT RIGHT SIDE OF DRIVEWAY



LOOKING SOUTH FROM LAWN AREA



LOOKING SOUTH FROM SUBDIVISION



LOOKING NORTH FROM DWELLING



LOOKING NORTH FROM WALKWAY



NORTH SIDE OF DWELLING



SEWER WATER OUTFALL




OWNER/APPLICANT

CANTERBURY STREET, LLC
15 LEWIS COURT
HINGHAM, MA 02043

AS-BUILT PLAN
111 WEIR STREET
HINGHAM, MA

SCALE: 1"=20' DATE: NOVEMBER 3, 2023

JAMES ENGINEERING, INC.
125 GREAT ROCK ROAD
HANOVER, MASS. 02339
TEL: 1- (781)-878-1795
email: jameseng125_gary@msn.com

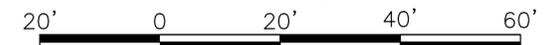

SCALE IN FEET

REV.#	DATE	DESCRIPTION
1	12/02/23	ADDED PHOTOS
2	03/07/25	REQUEST FOR CDC