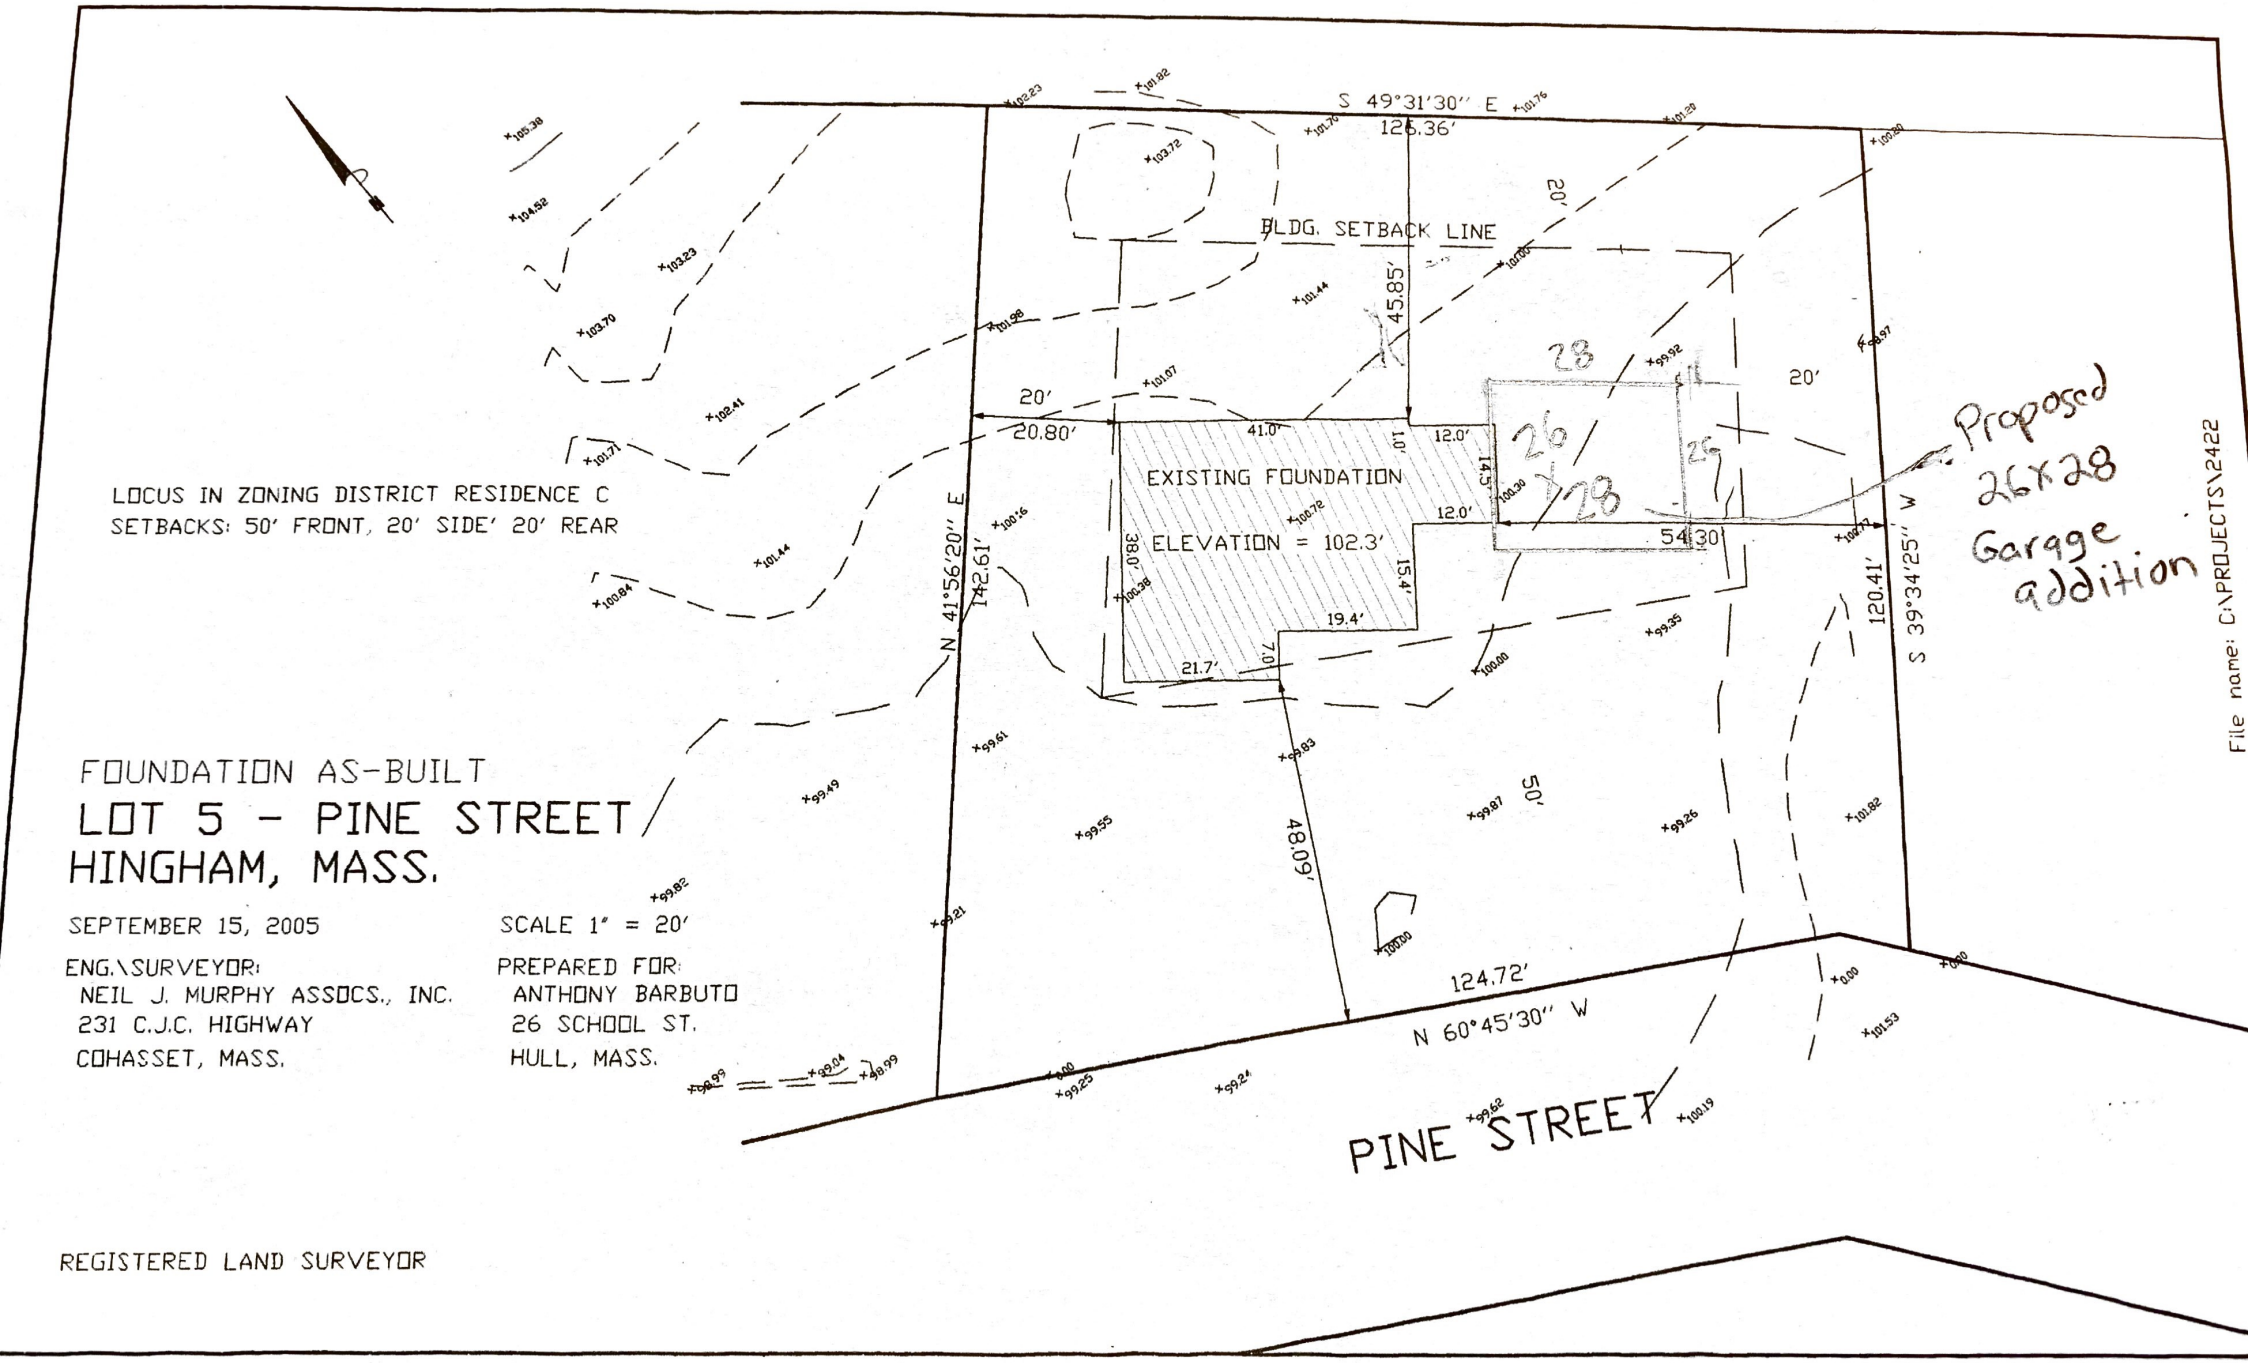
S 49°31'30" E
126.36'
BLDG. SETBACK LINE
20'
45.85'
20'
20'
20.80'
41.0'
12.0'
EXISTING FOUNDATION
ELEVATION = 102.3'
14.5'
12.0'
54.30'
38.0'
15.4'
19.4'
21.7'
7.10'
N 41°56'20" E
142.61'
120.41'
S 39°34'25" W
48.09'
50'
124.72'
N 60°45'30" W
PINE STREET
28
26
28
26
Proposed 26x28 Garage addition
LOCUS IN ZONING DISTRICT RESIDENCE C
SETBACKS: 50' FRONT, 20' SIDE' 20' REAR
FOUNDATION AS-BUILT
LOT 5 - PINE STREET
HINGHAM, MASS.
SEPTEMBER 15, 2005
SCALE 1" = 20'
ENG.\SURVEYOR:
NEIL J. MURPHY ASSOCS., INC.
231 C.J.C. HIGHWAY
COHASSET, MASS.
PREPARED FOR:
ANTHONY BARBUTO
26 SCHOOL ST.
HULL, MASS.
REGISTERED LAND SURVEYOR
File name: C:\PROJECTS\2422