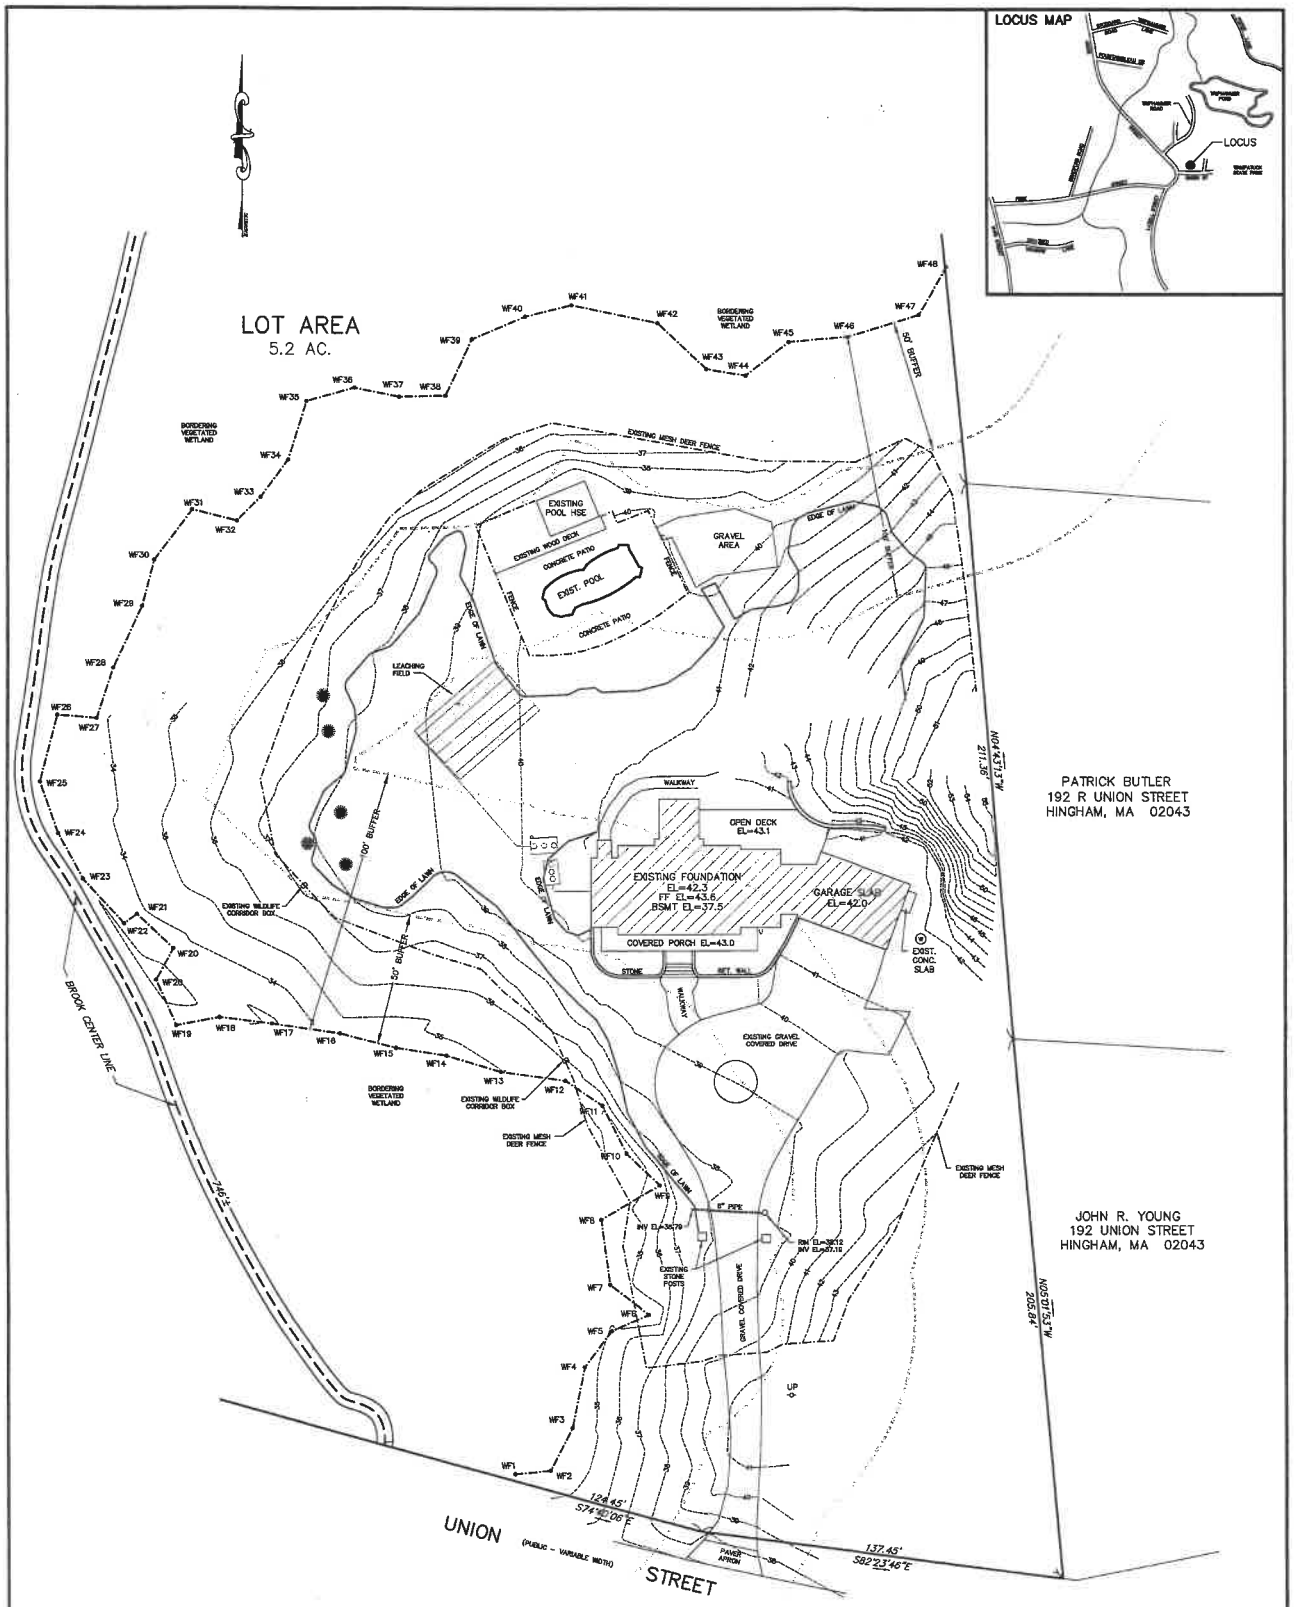

DEP FILE No. SE 34-1023

AS-BUILT PLAN

FOR

188 UNION STREET

IN

HINGHAM, MASS.

SCALE: 1"=40' MARCH 25, 2013

ROSS ENGINEERING COMPANY INC.

PROFESSIONAL ENGINEERS - LAND SURVEYORS

683 MAIN STREET
NORWELL, MASS. 02061
(781)659-1325

FEET 0 20 40 80 120 160
METERS 0 10 20 30 40 50

JN 3118-AB-2

OWNER

TERESA L. SIMMONS
188 UNION STREET
HINGHAM, MA 02643

COMMONWEALTH OF MASSACHUSETTS
GREGORY J. TANSEY
CIVIL
NO. 37210
REGISTERED PROFESSIONAL ENGINEER

RECEIVED
APR 16 2025
TOWN OF HINGHAM
CONSERVATION